


THANA - NALHATI
 MOUZA - PAIKPARA NO. 57
 BIRBHUM.

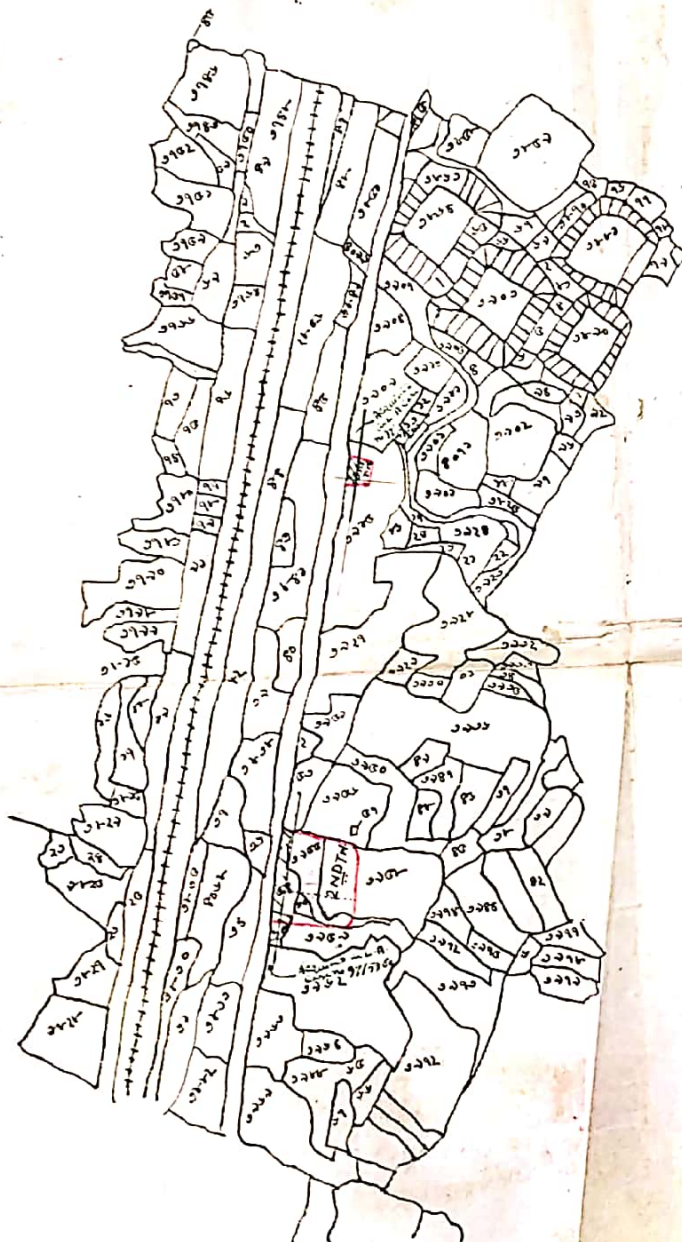

PROPOSED TUBEWELL SITE SHOWN IN RED.

GOVT. OF WEST BENGAL
 P.H. ENGINEERING DTE


THANA - NALHATI. MOUZA - PAIKPARA NO 57

DRG NO. 76/6-3/BRM-4 SCALE: 16" = 1 MILE

of Sarkar *Adarsh* *Ray*

DRAWN BY	A.E. BIRBHUM DIVN.	E.E. BIRBHUM DIVN.
----------	-----------------------	-----------------------

B L R B H U M

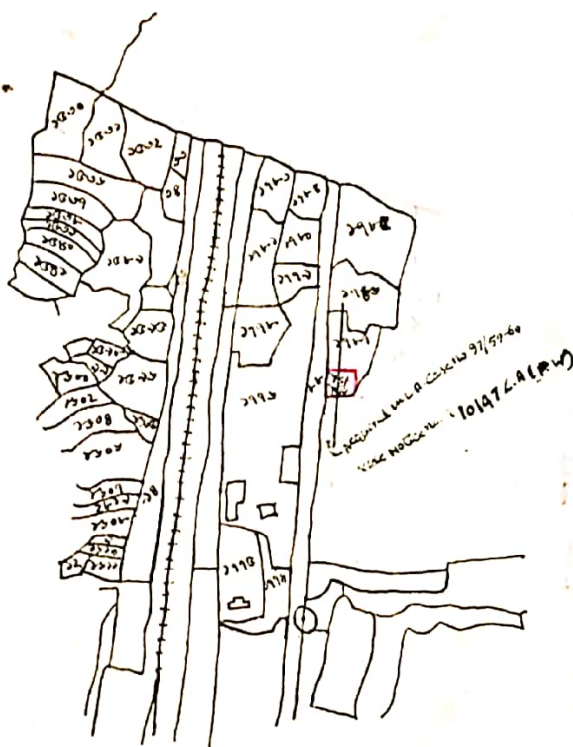

PROPOSED TUBEWELL SITE SHOWN IN RED.

MOUZA - NALHATI NO. 53.

DRG. NO. 76/6-2/3RM-3	SCALE: 16" = 1 MILE
-----------------------	---------------------

S. J. Jackson

Ordinary Ray

DRAWN BY


A.E.
BIRBHUM

E.E.
BIRBHUM DISTRICT



THANA - NALHATI.
MOUZA - PAIKPARA, NO-67.
DIST - BIRBHUM.
SCALE - 16" INCH = 1 MILE.


DRG. NO- 78/1-3/BRM-89.

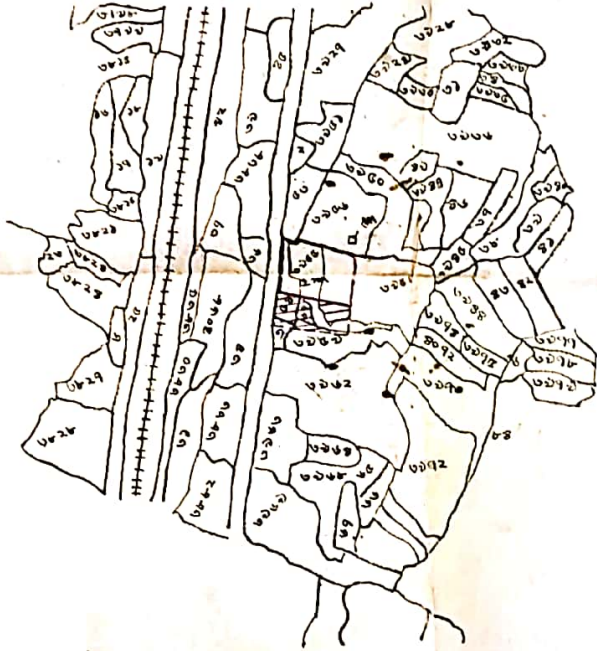


NOTE:-

1. LAND PROPOSED FOR HEAD WORK
SITE TO BE ACQUIRED SHOWN
THUS - 
2. LAND ALREADY ACQUIRED AND
POSSESSION DELIVERED TO BE
DEREQUISITIONED SHOWN THUS - 

B. Banerjee.
31/1/78
TRACED BY.

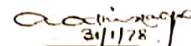
31/1/78
A. E.

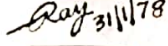
31/1/78
E. E.

BRM. DIVN. BRM. DIVN.
P. H. ENGINEERING DTE.
GOVT. OF WEST BENGAL.