[L.A. CASE NO. 8/85-86 (4)]

PLAN OF LAND TO BE ACQUIRED PERMANENTLY FOR BAKRESWAR THERMAL POWER PROJECT IN MOUZA - CHINPAI - J.L. NO 90 (SHEET NO.3) P.S. DUBRAJPUR AND DISTRICT - BIRBHUM.

SCALE = 330' FT = 1" INC

Ref: Railway Land Shown Thus :-
Land to be acquired Permt. Shown thus ...
Partly Vested & Partly retained Land shown thus ...
Vested Land Shown Thus :-
Forest Land Shown Thus :-

 

Schedule of Lands :-

Mouza & J.L. No.	P.S.	Dt.	C.S Plots nos in full & Part Plots.	Total area.
Chinpai. J.L. No. 90	Dubrajpur	Birbhum.	2845 to 2860, 2862 to 2871, 2873 to 2877, 2876 in retain Portion, 2877 to 2879, 2880 in retain Portion, 2881, 2882 in retain Portion, 2883, 2884, 2889 to 2982, 2984 to 2988, 2990 to 2995, 2891/3382, 2915/3398, 2915/3399, 2915/3400, 2888/3401, 2921/3429, 2888/3436, 2888/3437, 2888/3440, ~~2821/3495~~, 2896/3496, 2896/3497, 2897/3498, 2934/3500, 2921/3501, 2921/3502, 2974/3503, 2974/3504, 2888/3542, 2888/3543, 2888/3544 and 2888/3545. in full Plots. 2843, 2989, 2996, 2997, 3007, 3008, 3008/3404 in Part Plots.	62.8837 ~~64.0337~~ in acres or ~~25.4979~~ ~~26.2971~~ (hects.).

Prepared by :- 21.7.86.

Checked 11.8.86

SPL. L.A. OFFICER, BIRBHUM.

ADDL. DIST. MAGISTRATE BIRBHUM.

Scanned with CamScanner